


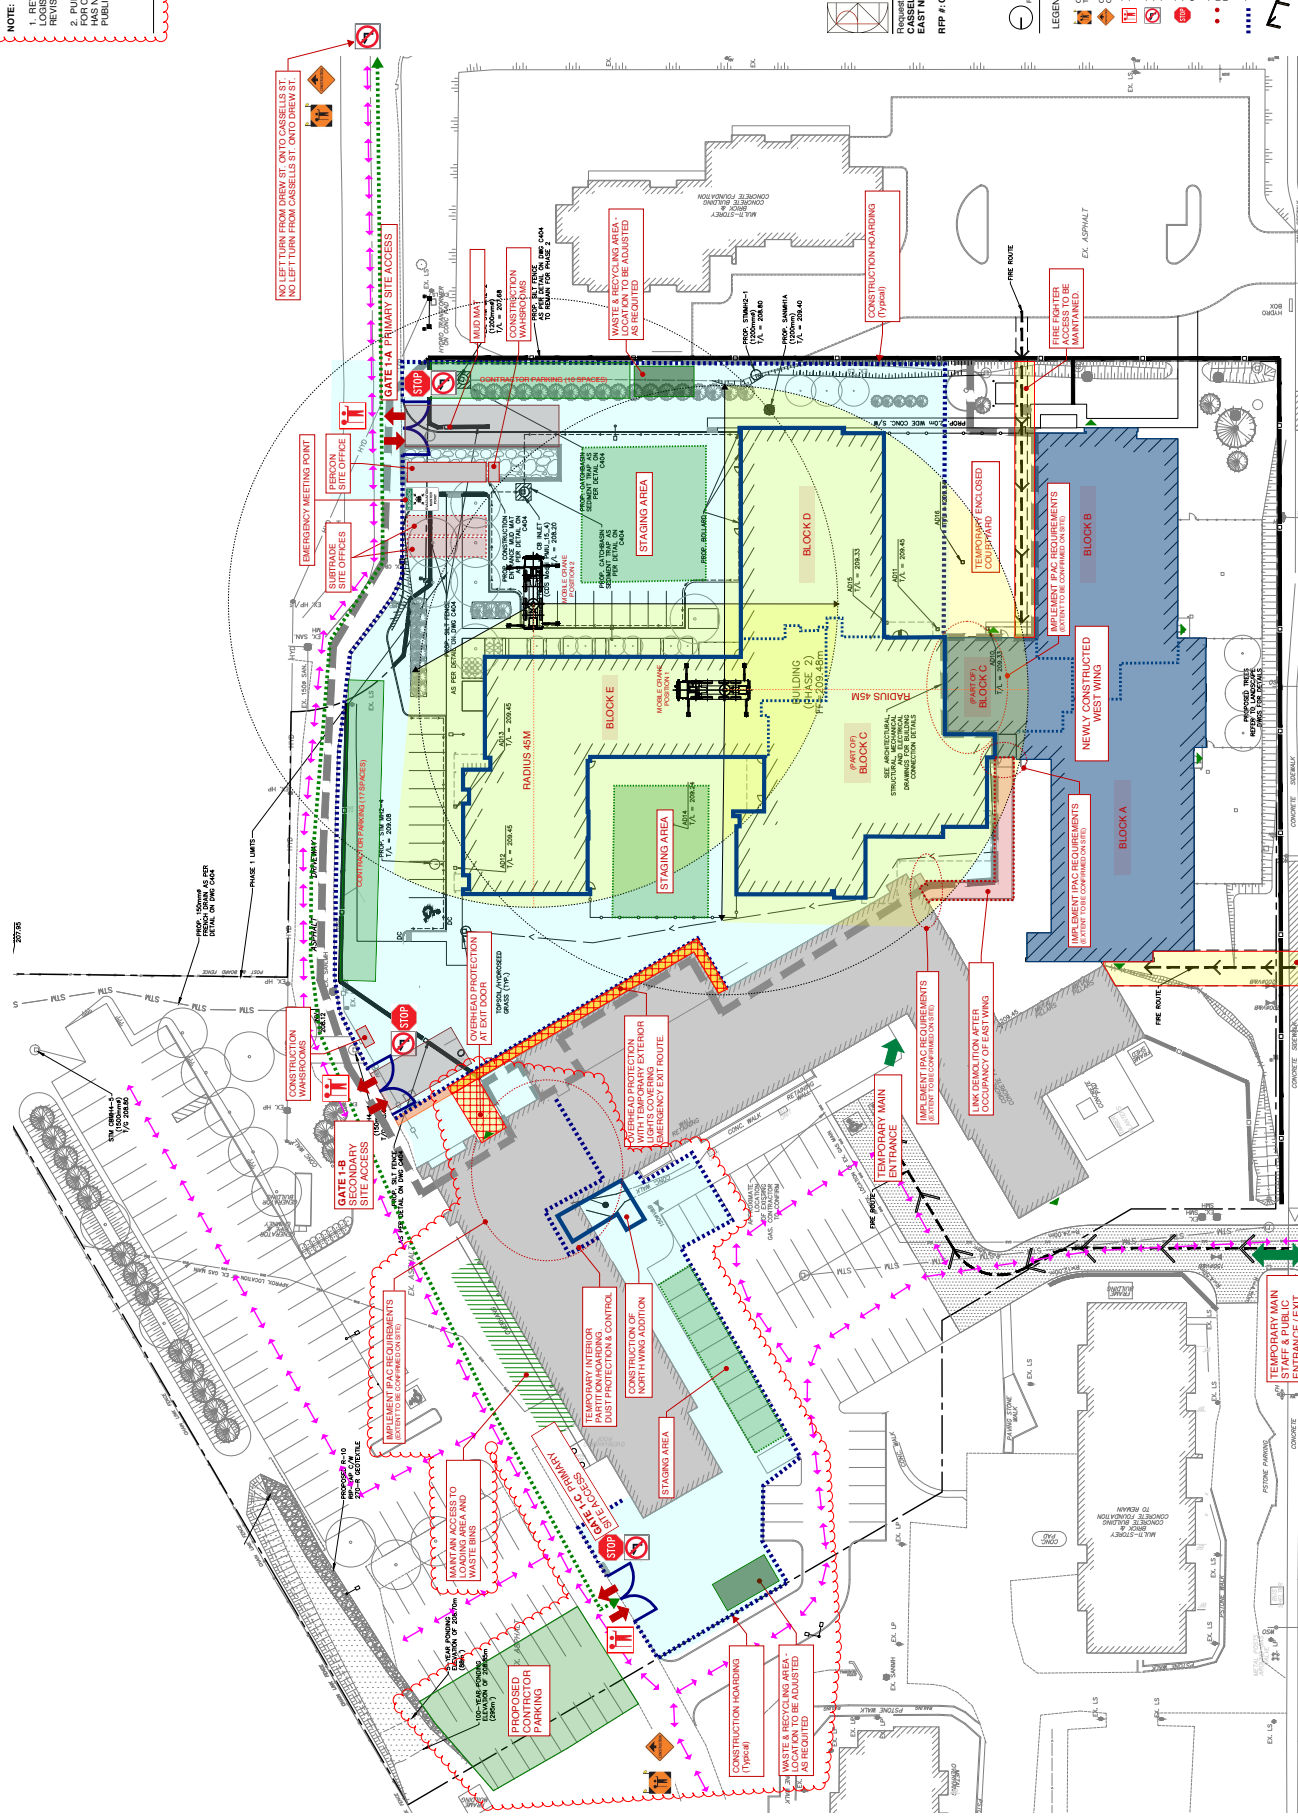

NOTE:
1. REVISIONS/CHANGES TO PREVIOUSLY ISSUED LOGISTICS PLANS HAVE BEEN INDICATED WITH RED LINES AND CALLOUTS.
2. PUBLIC TRAFFIC ROUTES HAVE BEEN ADDED FOR CLARITY. THE TRAFFIC ROUTE ON THE PLANS HAS NOT BEEN CLOUDED. REFER TO LEGEND FOR PUBLIC TRAFFIC ROUTE IDENTIFICATION SYMBOL.

PERCON
CONSTRUCTION INC.
Prepared for: Percon
CASSELQUIRE REDEVELOPMENT
EAST HISSING HOME FOR THE AGED
RFP # CH-2020-010

LEGEND	
	CONSTRUCTION BARRIER
	TRAFFIC CONTROL POINT
	CONSTRUCTION SITE ACCESS
	CONSTRUCTION GATE
	NEW CONSTRUCTION
	BUILDING DEMOLITION
	EXISTING BUILDING
	EMERGENCY EXIT
	PUBLIC TRAFFIC ROUTE
	CONSTRUCTION TRAFFIC ROUTE
	CONSTRUCTION SITE ACCESS
	CONSTRUCTION GATE
	NEW CONSTRUCTION
	BUILDING DEMOLITION
	EXISTING BUILDING
	EMERGENCY EXIT
	PUBLIC TRAFFIC ROUTE
	CONSTRUCTION TRAFFIC ROUTE
	CONSTRUCTION SITE ACCESS
	CONSTRUCTION GATE
	NEW CONSTRUCTION
	BUILDING DEMOLITION
	EXISTING BUILDING
	EMERGENCY EXIT

LOGISTICS PLAN
PHASE 2-B
NOT TO SCALE

DATE: 16 MARCH 2021
DRAWING NO: LG-005